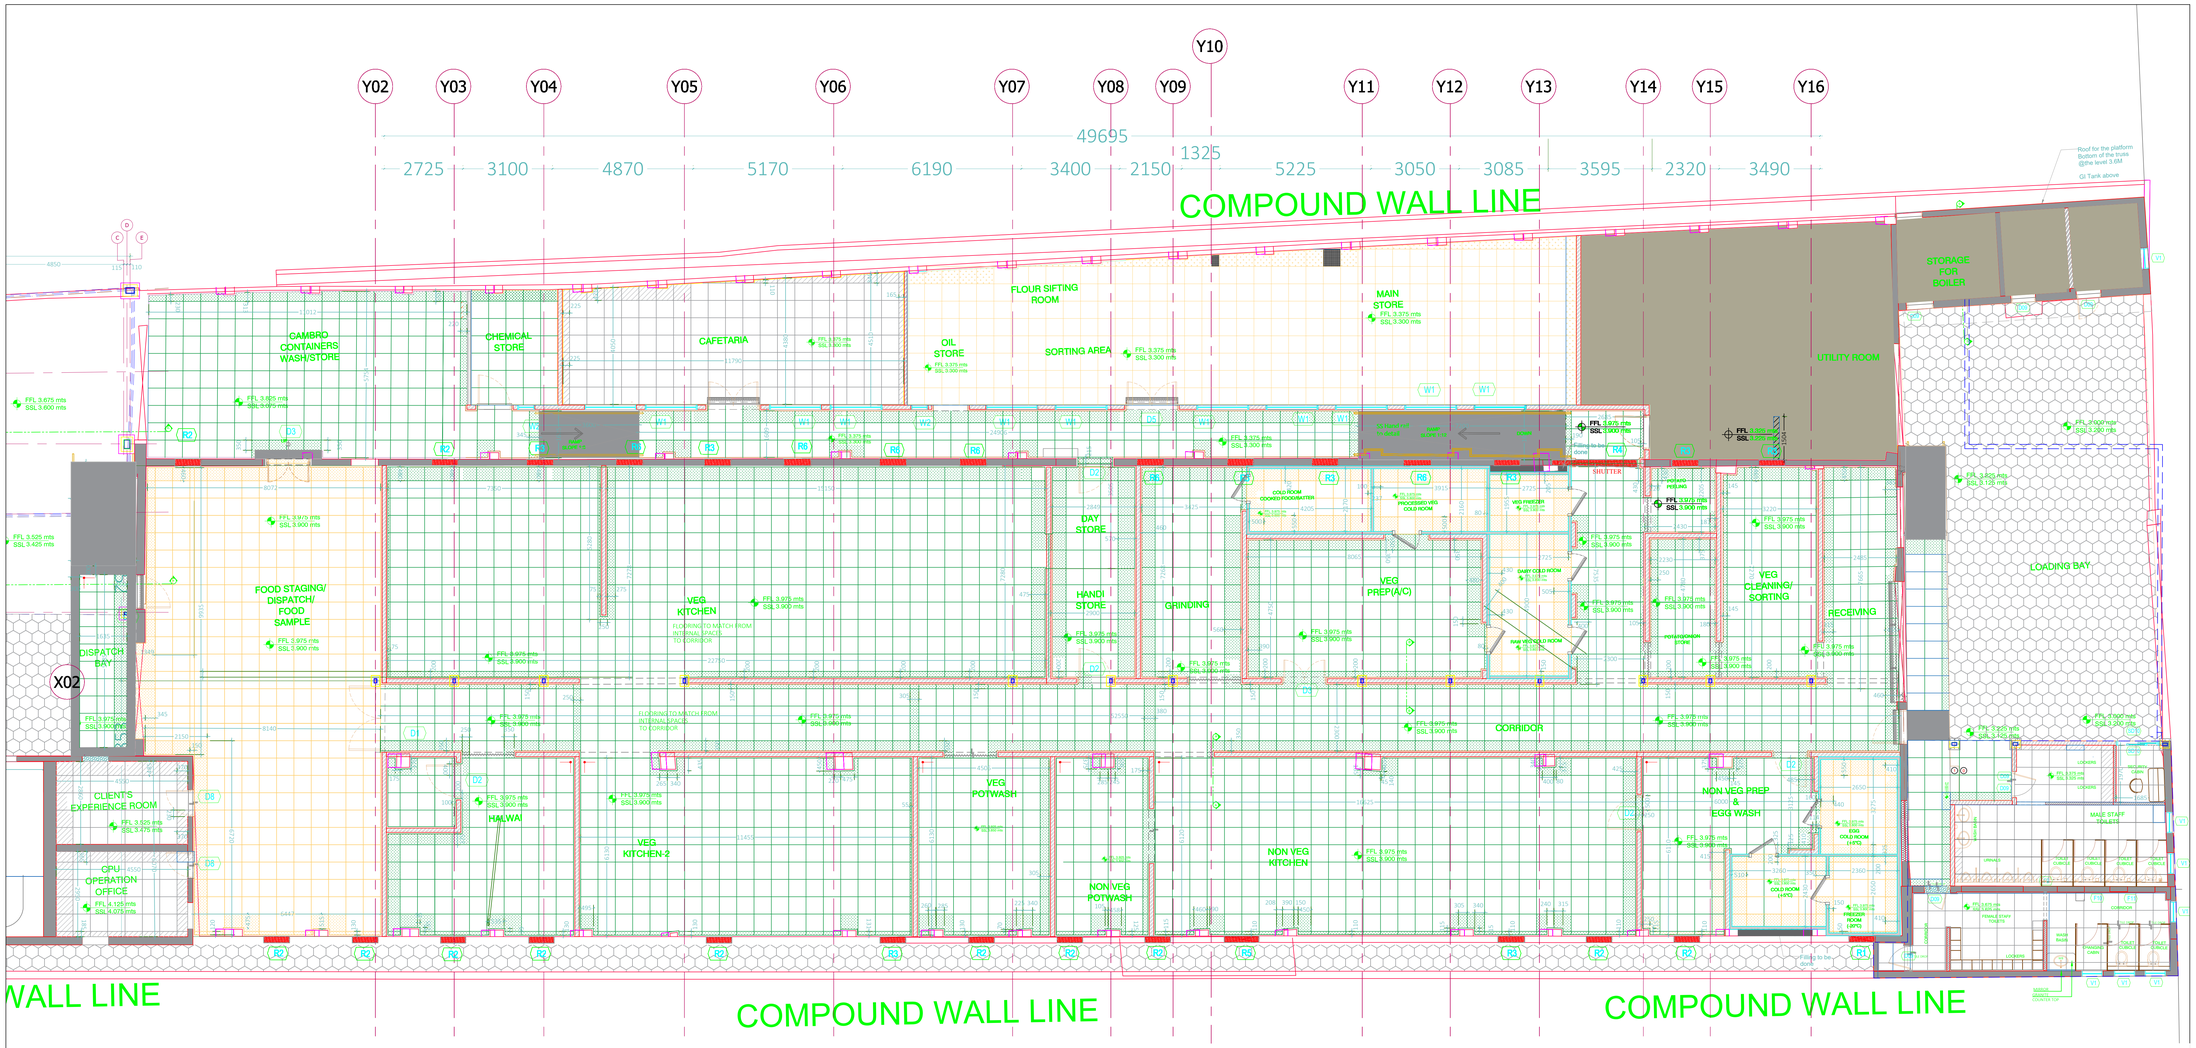


FLOORING LAYOUT

NOTE:FLOORING TO MATCH INTERNAL SPACES FROM CORRIDOR
DADO FOR THE CLADING TO FOLLOW FLOORING GROOVE LINES

LEGEND

- 40 mm THICK (600 x 600) PRE POLISHED KOTA CUTTING
- 20 mm THICK (600 x 600) PRE POLISHED KOTA CUTTING
- 600 X600 VITRIFIED TILES CUTTING TILES
- 40 mm THICK (600 x 600) PRE POLISHED KOTA
- 20 mm THICK (600 x 600) PRE POLISHED KOTA
- 600 X600 VITRIFIED TILES
- PAVER BLOCK FOR PARKING
- 19mm GRANITE SADAR ALI FLAMED FINISH
- 100 mm THICK CONCRETE

NOTES:

1- All dimensions are in metres.
2- All drawings are the sole property of "DESIGN TRANSCEND"
3- No part of this drawing should be reproduced, copied or exchanged without the written permission of the architect.
4- Refer dimensions for actual dimensions. Do not measure from the drawing.

STRUCTURAL DESIGN:

SRI SAI ENGINEERS
SERVICE - SPLENDID - EVERLASTING
No.243, 3rd Main, Kirloskar Layout
Nagasandra Post, Bangalore-560073.
Tel No. +919731754659,
Email : anand@srisaiengg.com,
Website : www.srisaiengg.com

MEP DESIGN:

maverick
SERVICE CONSULTANTS

MEP CONSULTANTS :
MAVERICK SERVICE CONSULTANTS
#48, 7th Main,
4th Block, Jaya nagar,
Bangalore-560011.

ARCHITECTS:

DESIGN TRANSCEND
Transforming lives through design
3rd Floor, Rishab Arcade, Sanjay Nagar Main Rd
Raj Mahal Vilas 2nd Stage, Bengaluru - 560094

CLIENT:

COMPASS GROUP
Plot No 1478 and 1628,
EE Industrial Estate, OMR, Perungudi,
Chennai - 600 096.

CONTRACTOR

RIYA ENTERPRISES
Second Floor, C-19,
Dilshad Colony, New Delhi
110095 (Above SBI Bank)
Email: facilities@riyaenterprises.in

PROJECT NAME:

COMPASS CPU,
CHENNAI

DRAWING NAME:

AS - BUILT FLOORING LAYOUT

REVISIONS :

NO.	DATE	DESCRIPTION

REFERENCE

AR | CPU | 101

DATE: 19TH MARCH 2026

DRAWN BY:	CHECKED BY:
MOHIT KUMAR	MR. SARIM

SCALE 1:100
SHEET A0
N