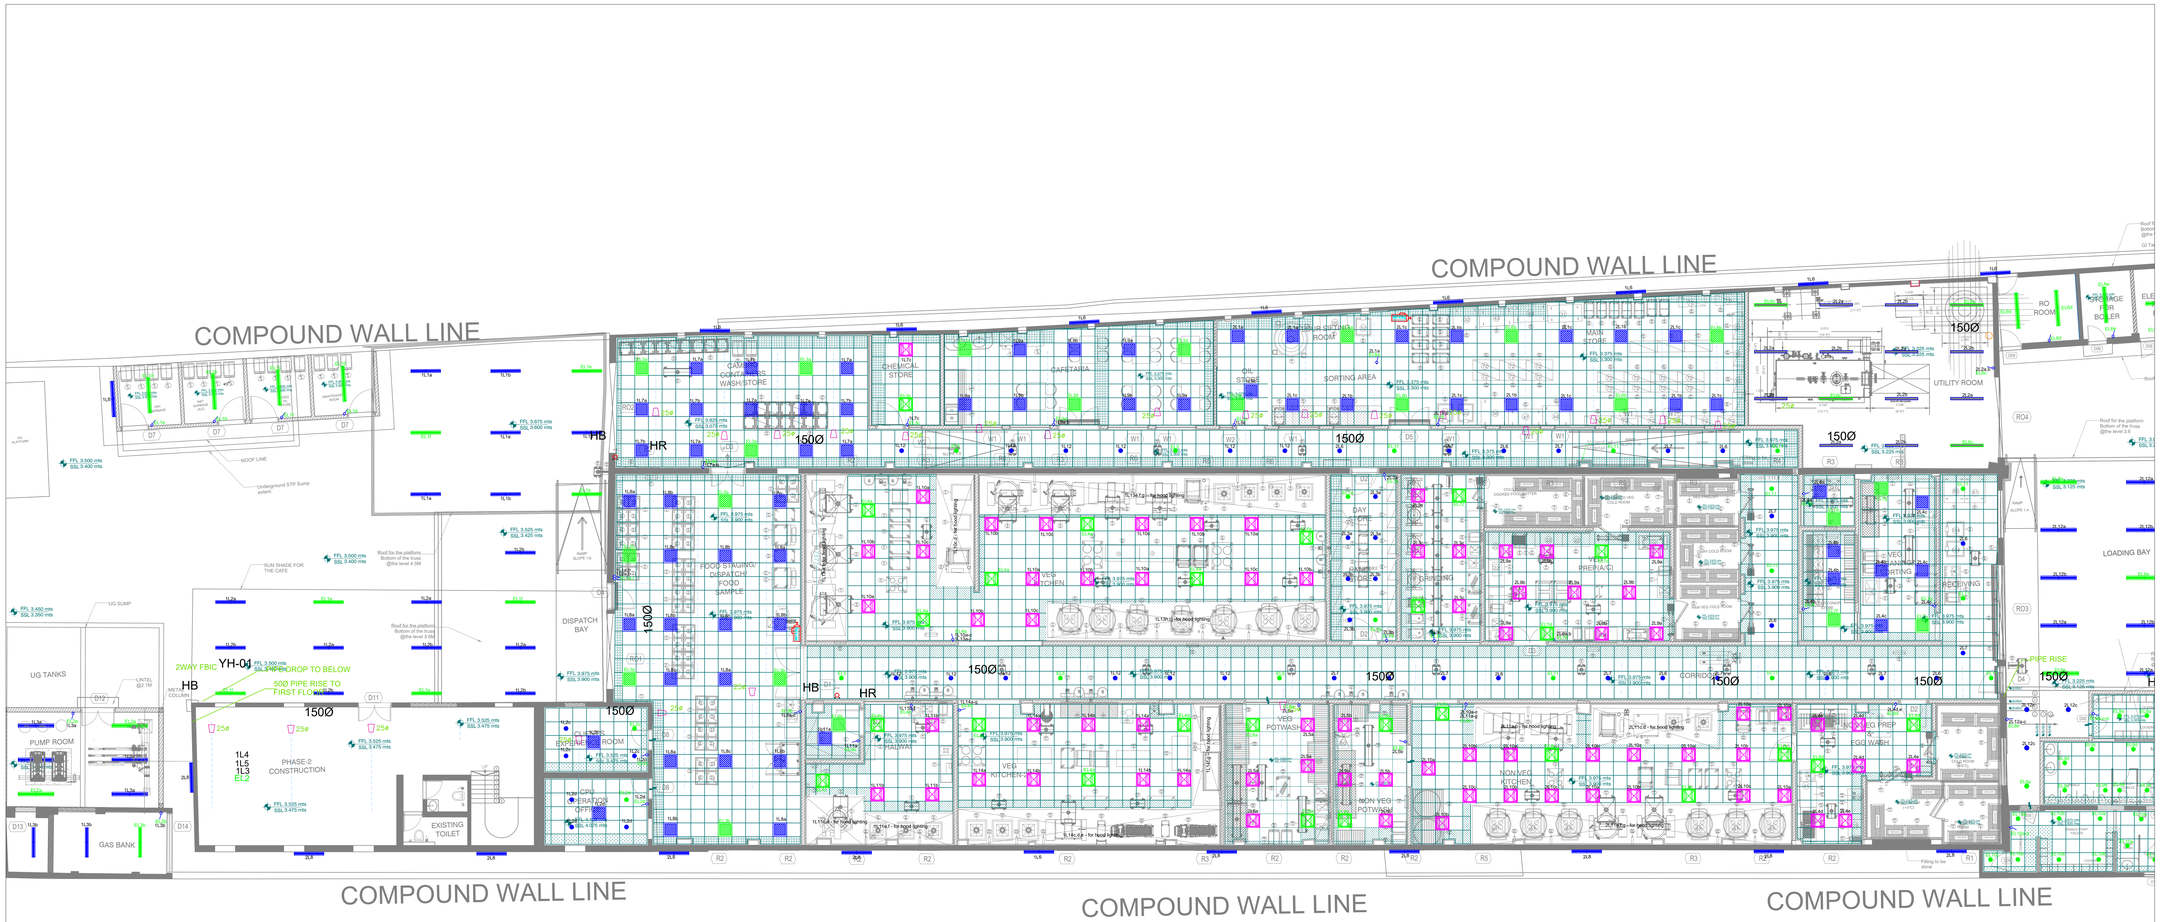



## CIRCUIT DESCRIPTION

L-1-a
- Switch control no.
- Circuit number
- Lighting circuit

## CIRCUIT DESCRIPTION

L- 1
- Circuit number
- Lighting circuit

## CIRCUIT DESCRIPTION

E-L-1-a
- Switch control no.
- Circuit number
- Lighting circuit
- Emergency

## LIGHTING NOTES :-

1) CIRCUIT BELONGING TO THE DIFFERENT PHASES SHOULD NOT BE DRAWN IN THE SAME CONDUIT & SWITCHES/SOCKETS IN SEPARATE BOXES FOR SEPARATE CIRCUITS

2) COLOUR CODING SHALL BE ADAPTED AS RED, YELLOW, BLUE FOR PHASE, BLACK FOR NEUTRAL AND GREEN FOR EARTH WIRE.

3) ALL THE DB'S SHALL BE BONDED TO THE GROUND BUS.

4) MOUNTING HEIGHT FOR THE SWITCH BOXES SHALL BE 1200MM FROM THE FINISHED FLOOR LEVEL (FFL).

5) SEPARATE CIRCUITS TO BE TAKEN FOR THE EMERGENCY LIGHTS FROM THE ELDB.

6) 100MM CLEAR SPACE TO BE PROVIDED ABOVE THE FALSE CEILING FOR LIGHT FIXTURE INSTALLATION.

7) ALL LUMINAIRS HAVING SHEET STEEL/CI/ALUMINIUM BODIES SHALL BE EARTHED.

8) ANY SWITCH BOX SHOWN ON THE EDGE OF THE WALL SHALL BE 150MM AWAY FROM THE EDGE.

9) THE GAP BETWEEN THE TWO SWITCH BOXES PLACED SIDE BY SIDE SHALL BE 25MM.

10) LIGHTING CIRCUIT MAINS SHALL BE IN 19MM DIA PVC CONDUIT WITH 2 X 2.5SQMM + 1 X 2.5 SQMM FRLS PVC INSULATED STRANDED COPPER CONDUCTOR WIRES WITH COLOUR CODING AS PER IS 732.

11) POWER POINT CONTROLS AND LIGHT POINT CONTROLS HAS TO BE IN DIFFERENT BOXES WITH MINIMUM GAP OF 25MM BETWEEN THE TWO.

12) WHEREVER THE DB'S ARE PRESENT, 6"/8" WALL TO BE PROVIDED.

## LIGHT LEGENDS.

| SYMBOL | DESCRIPTION |
|---|---|
| | 40W LED batten light fixture<br>Make: Wipro LL24-541-XXX-57-XX or any similar make. |
| | 1.2 Mtr 40W Industrial, IP65 Batten light fixture<br>Make: Wipro LE23-491-XXX-57-XX or any similar make. |
| | 36W 2X2 Recessed mounted light fixture - IP20<br>Make: Wipro CRCO10R040HP57G4 or any similar make. |
| | 42W 2X2 Bottom openable Recessed mounted light - IP65<br>Make: Wipro LC20-551-XXX-57-G2 or any similar make. |
| | 15W Recess Mounted Circular Light fixture.<br>Make: Wipro LD06-171-XXX-57-XX or any similar make. |
| | 15W Surface Mounted Circular Light fixture.<br>Make: Wipro LD06-171XXX-57SMG1 or any similar make. |
| | 6A SP Switch for lighting control |

## NOTES:

1- All dimensions are in metres.
2- All drawings are the sole property of "DESIGN TRANSCEND"
3- No part of this drawing should be reproduced, copied or exchanged without the written permission of the architect.
4- Refer dimensions for actual dimensions. Do not measure from the drawing.

**STRUCTURAL DESIGN:**

SRI SAI ENGINEERS
SERVICE - SPLENDID - EVERLASTING
No.243, 3rd Main, Kirloskar Layout
Nagasandra Post, Bangalore-560073.
Tel No. +919731754659,
Email : anand@srisaienegg.com,
Website : www.srisaienegg.com

**MEP DESIGN:**

maverick
SERVICE CONSULTANTS

MEP CONSULTANTS :
MAVERICK SERVICE CONSULTANTS
#48, 7th Main,
4th Block, Jaya nagar,
Bangalore-560011.

**ARCHITECTS:**

DESIGN TRANSCEND
Transforming lives through design
3rd Floor, Rishab Arcade, Sanjay Nagar Main Rd
Raj Mahal Vilas 2nd Stage, Bengaluru - 560094

**CLIENT:**

COMPASS GROUP
Plot No 147B and 162B,
EE Industrial Estate, OMR, Perungudi,
Chennai - 600 096.

CONTRACTOR
RIYA ENTERPRISES
Second Floor, C-19,
Dilshad Colony, New Delhi
110095 ( Above SBI Bank)
Email: facilities@riyaenterprises.in

**PROJECT NAME:**

COMPASS CPU,
CHENNAI

**DRAWING NAME:**

AS - BUILT LIGHTING LAYOUT

**REVISIONS :**

| NO. | DATE | DESCRIPTION |
|---|---|---|
| | | |

**REFERENCE**

AR | CPU | 101

**DATE:** 16 TH JULY 2026

| DRAWN BY: | CHECKED BY: |
|---|---|
| MOHIT KUMAR | MR. SARIM |

SCALE 1:100
SHEET A0
N