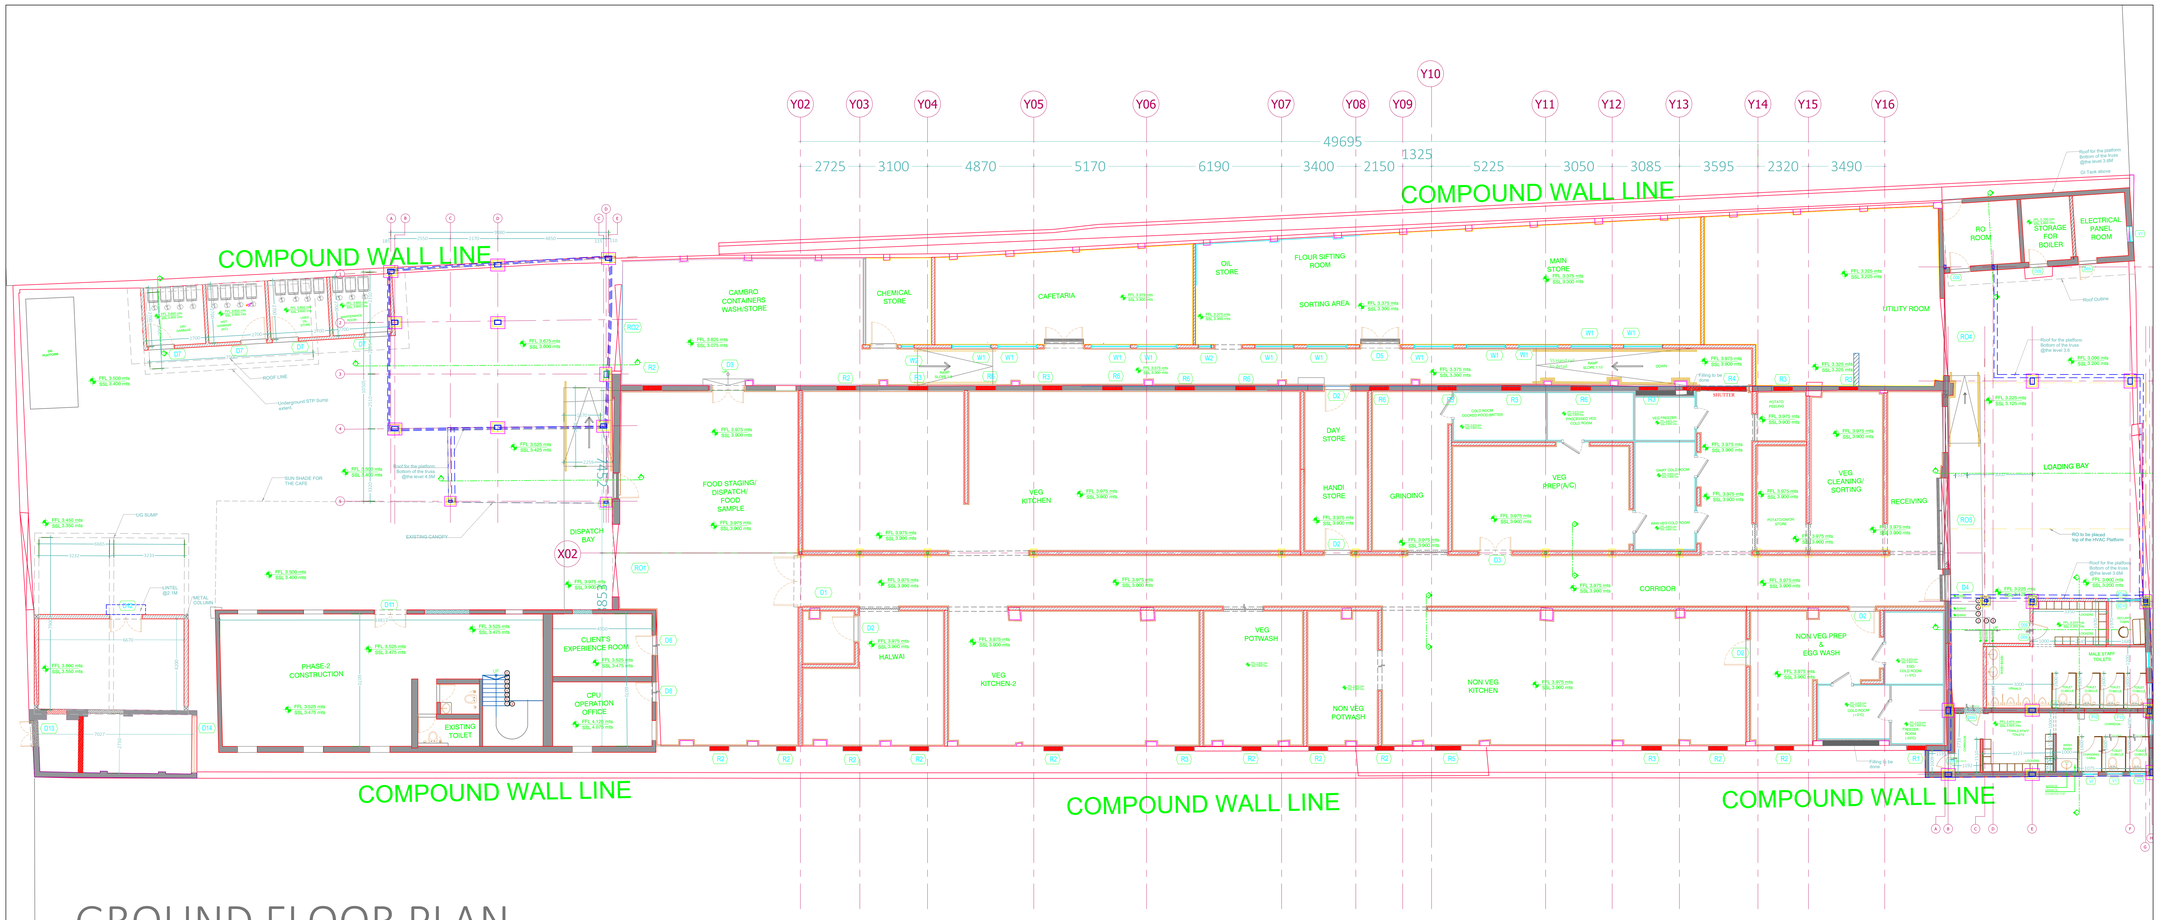


GROUND FLOOR PLAN


LEGEND


- EXISTING WALL
- 150 mm THK, 1200 mm HT LOW HEIGHT WALL
- 150 mm THK ADD-ON WALL
- 100 mm THK ADD-ON WALL


SCHEDULE OF ROLLING SHUTTER OPENING		
RO1	3.30 W x 3.00 H	ROLLING SHUTTER 1 (USING THE EXISTING ONE)
RO2	3.99 W x 3.53 H	ROLLING SHUTTER 2 (USING THE EXISTING ONE)
RO3	4.17 W x 3.35 H	ROLLING SHUTTER 3 (USING THE EXISTING ONE)
RO4	3.53.4 W x 3.35 H	ROLLING SHUTTER 3 (USING THE EXISTING ONE)

DOOR NAME	DOOR TYPE	DOOR SIZE	DESCRIPTION
D1	FIRE DOOR,DOUBLE LEAF METAL DOOR	2.35 W x 2.10 H	DOOR OPENING TO FOOD DISPATCH
D2	NON-FIRE DOOR,SINGLE LEAF METAL DOOR	1.20 W x 2.10 H	DOOR OPENING TO PRODUCT STORE,NON-VEG KITCHEN NON-VEG PREP,ENTRY AND EXIT DAY STORE
D3	NON-FIRE DOOR,DOUBLE LEAF METAL DOOR	1.50 W x 2.10 H	DOOR OPENING TO VEG PREP AC AND FOOD STAGING
D4	FIRE DOOR,SINGLE LEAF METAL DOOR	1.20 W x 2.10 H	DOOR OPENING TO ENTRANCE TO KITCHEN
D5	NON-FIRE DOOR,DOUBLE LEAF METAL DOOR	1.80 W x 2.10 H	DOOR OPENING TO MAIN STORE
D6	UPVC,SINGLE LEAF UPVC DOOR	1.20 W x 2.10 H	DOOR OPENING TO DETERGENT STORE,HK MATERIAL STORE, NON FOOD STORE,DRY GARBAGE,WET GARBAGE,USED OIL STORE
D7	UPVC,SINGLE LEAF UPVC DOOR	1.20 W x 2.10 H	DOOR OPENING TO DRY GARBAGE,WET GARBAGE, USED OIL STORE AND MAINTENANCE ROOM
D8	EXISTING DOOR	0.950 W x 2.10 H	DOOR OPENING TO CPU OPERATION OFFICE
D9	UPVC,SINGLE LEAF UPVC DOOR	0.90 W x 2.10 H	DOOR OPENING TO STORAGE FOR BOILER,ELE PANEL ROOM AND RO ROOM TOILET OPENING
SD10	UPVC,SLIDING UPVC DOOR	1.50 W x 2.10 H	DOOR OPENING TO SECURITY CABIN
D11	UPVC,DOUBLE LEAF UPVC DOOR	1.50 W x 2.10 H	DOOR OPENING TO CAFETARIA
D12	NON-FIRE DOOR,DOUBLE LEAF METAL DOOR	1.50 W x 2.10 H	DOOR OPENING TO PUMP ROOM
D13	DOUBLE LEAF MESH DOOR	1.20 W x 2.10 H	DOOR OPENING TO GAS BANK
D14	MESH DOOR	2.60 W x 2.10 H	DOOR OPENING TO GAS BANK

SCHEDULE OF WINDOW OPENING		
W01	1.80 W x 0.9 H	VENTILATOR OPENING 1
W02	0.60 W x 0.9 H	VENTILATOR OPENING 2
V1	0.750 W x 0.9 H	VENTILATOR OPENING 1

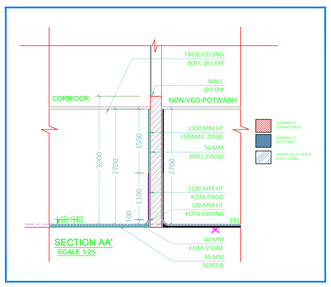

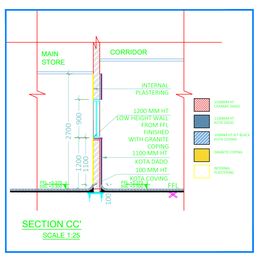

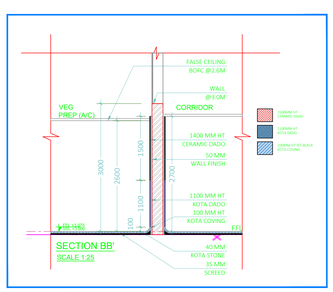

LEGEND

- 100 mm HT KOTA COVING, 900 mm HT KOTA DADO, 200 mm HT GRANITE DADO, 1400 mm HT CERAMIC DADO
- 2150 mm HT CERAMIC DADO
- 1500 mm HT SS SHEET DADO
- 100 mm HT KOTA COVING, 900 mm HT KOTA DADO, 200 mm HT GRANITE DADO, GRANITE COPING
- INTERIOR DESIGN FEATURE, 2700MM HT OF WALL PUTTY, 2700 INTERIOR WALL PAINTING

NOTES:

1- All dimensions are in metres.
2- All drawings are the sole property of "DESIGN TRANSCEND"
3- No part of this drawing should be reproduced, copied or exchanged without the written permission of the architect.
4- Refer dimensions for actual dimensions. Do not measure from the drawing.

STRUCTURAL DESIGN:

SRI SAI ENGINEERS
SERVICE - SPLENDID - EVERLASTING
No.243, 3rd Main, Kirloskar Layout
Nagasandra Post, Bangalore-560073.
Tel No. +919731754659,
Email : anand@srisaienegg.com,
Website : www.srisaienegg.com

MEP DESIGN:

maverick
SERVICE CONSULTANTS

MEP CONSULTANTS :
MAVERICK SERVICE CONSULTANTS
#48, 7th Main,
4th Block, Jaya nagar,
Bangalore-560011.

ARCHITECTS:

DESIGN TRANSCEND
Transforming lives through design
3rd Floor, Rishab Arcade, Sanjay Nagar Main Rd
Raj Mahal Vilas 2nd Stage, Bengaluru - 560094

CLIENT:

COMPASS GROUP
Plot No 1478 and 1628,
EE Industrial Estate, OMR, Perungudi,
Chennai - 600 096.

CONTRACTOR
RIYA ENTERPRISES
Second Floor, C-19,
Dilshad Colony, New Delhi
10095 (Above SBI Bank)
Email: facilities@riyaenterprises.in

PROJECT NAME:

COMPASS CPU,
CHENNAI

DRAWING NAME:

AS - BUILT MASONRY LAYOUT

REVISIONS :

NO.	DATE	DESCRIPTION

REFERENCE

AR | CPU | 101

DATE: 19TH JULY 2026

DRAWN BY:	CHECKED BY:
SHUGEETHA	VAMSI VARMA

SCALE 1:100
SHEET A0
N