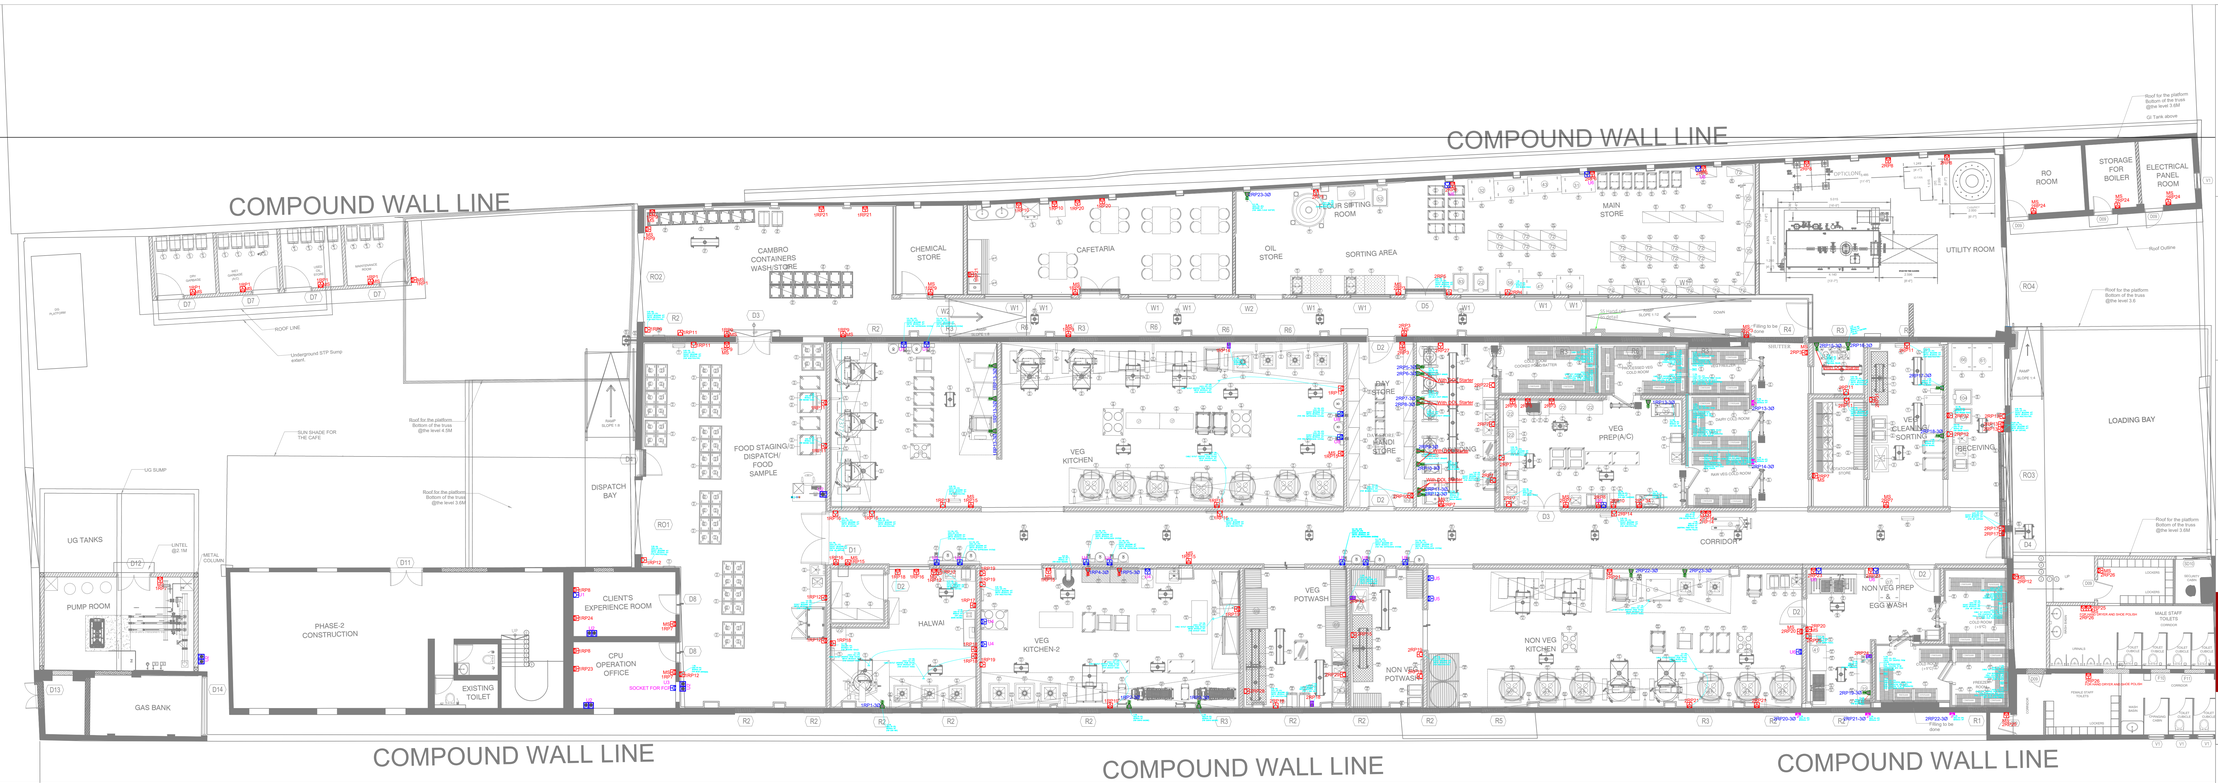


GROUND FLOOR PLAN

NOTE:ALL THE LINES TO BE PERPENDICULAR TO EACH OTHER
COLUMN AREA TO BE FINISHED PROPERLY SO THE DADO IS IN LINE

LEGEND

- EXISTING WALL
- 150 mm THK, 1200 mm HT LOW HEIGHT WALL
- 150 mm THK ADD-ON WALL
- 100 mm THK ADD-ON WALL

CIRCUIT DESCRIPTION

R-P-1
- Circuit number
- Power
- Raw

CIRCUIT DESCRIPTION

U- 1
- Circuit number
- UPS

CIRCUIT DESCRIPTION

AC- 1
- Circuit number
- AC – VRV

POWER NOTES:-

1. CIRCUIT BELONGING TO THE DIFFERENT PHASES SHALL NOT BE DRAWN IN THE SAME CONDUIT.
2. POWER CIRCUIT MAINS SHALL BE IN 25MM DIA MS CONDUIT WITH 2R X 4.0SQMM +1R X 2.5 SQMM (EARTH) PVC INSULATED STRANDED CONDUCTOR FRLS WIRES WITH COLOUR CODING AS PER IS 732.
3. SWITCH BOX FOR LIGHTING AND POWER CIRCUITS SHOULD BE SEPARATE.
4. ANY SWITCH BOX SHOWN ON THE EDGE OF THE WALL SHALL BE 150MM AWAY FROM THE EDGE.
5. COLOUR CODING SHALL BE ADAPTED AS RED, YELLOW, BLUE FOR PHASE, BLACK FOR NEUTRAL AND GREEN FOR EARTHING.
6. CONDUIT TERMINATIONS IN SWITCH BOXES SHALL HAVE CHECKNUTS.
7. RAW POWER CIRCUITS SHALL BE DRAWN FROM RPDB & UPS POWER CIRCUITS SHALL BE DRAWN FROM UPSDB
8. ALL MCB DB'S SHALL BE BONDED TO THE GROUND BUS.
9. THE CONDUIT ARE SHOWN AS CURVED FOR CLARITY AND TO AVOID CONFUSION BETWEEN CONDUITS. THE CONDUITS SHALL BE LAID STRAIGHT AND SHALL BE FIXED TO THE ROOF SLAB.

SOCKETS LEGENDS :

SYMBOL	DESCRIPTION
	2Nos 6A Socket Outlets Controlled by 2x6A SP Switch (UPS Power)
	2Nos 6A Socket Outlets Controlled by 2x6A SP Switch (Raw Power)
	1No 16A Socket Outlet Controlled By 16A SP Switch (UPS Power)
	1No 16A Socket Outlet Controlled By 16A SP Switch (Raw power)
	1No 6A Socket Outlet Controlled By 6A SP Switch (UPS power)
	1No 6A Socket Outlet Controlled By 6A SP Switch (Raw power)
	3Nos 6/13A Universal Socket Outlets Controlled by 16A SP Switch (UPS Power)
	16A 1Ø Industrial Plug top Socket with 16A DP RCBO (Raw Power)
	32A 1Ø Industrial Plug top Socket with 32A DP RCBO (Raw Power)
	16A 3Ø Industrial Plug top Socket with 16A 4P RCBO (Raw Power)
	32A 3Ø Industrial Plug top Socket with 32A 4P RCBO (Raw Power)
	63A 3Ø Industrial Plug top Socket with 63A 4P RCBO (Raw Power)
MS	Maintenance socket
	32A FP isolator & surface mounted box
	Data point
	Telephone point

NOTES:

1- All dimensions are in metres.
2- All drawings are the sole property of "DESIGN TRANSCEND"
3- No part of this drawing should be reproduced, copied or exchanged without the written permission of the architect.
4- Refer dimensions for actual dimensions. Do not measure from the drawing.

STRUCTURAL DESIGN:

SRI SAI ENGINEERS
SERVICE - SPLENDID - EVERLASTING
No.243, 3rd Main, Kirloskar Layout
Nagasandra Post, Bangalore-560073.
Tel No. +919731754659,
Email : anand@srisaiengg.com,
Website : www.srisaiengg.com

MEP DESIGN:

maverick SERVICE CONSULTANTS

MEP CONSULTANTS :
MAVERICK SERVICE CONSULTANTS
#48, 7th Main,
4th Block, Jaya nagar,
Bangalore-560011.

ARCHITECTS:

DESIGN TRANSCEND
Transforming lives through design
3rd Floor, Rishab Arcade, Sanjay Nagar Main Rd
Raj Mahal Vilas 2nd Stage, Bengaluru - 560094

CLIENT:

COMPASS GROUP
Plot No 1478 and 1628,
EE Industrial Estate, OMR, Perungudi,
Chennai - 600 096.

CONTRACTOR
RIYA ENTERPRISES
Second Floor, C-19,
Dilshad Colony, New Delhi
0095 (Above SBI Bank)
Email: facilities@riyaenterprises.in

PROJECT NAME:
COMPASS CPU,
CHENNAI

DRAWING NAME:
AS - BUILT POWER LAYOUT

REVISIONS :

NO.	DATE	DESCRIPTION

REFERENCE
AR | CPU | 101

DATE: 18TH JULY 2026

DRAWN BY:	CHECKED BY:
MOHIT KUMAR	MR. SARIM

SCALE 1:100
SHEET A0
N