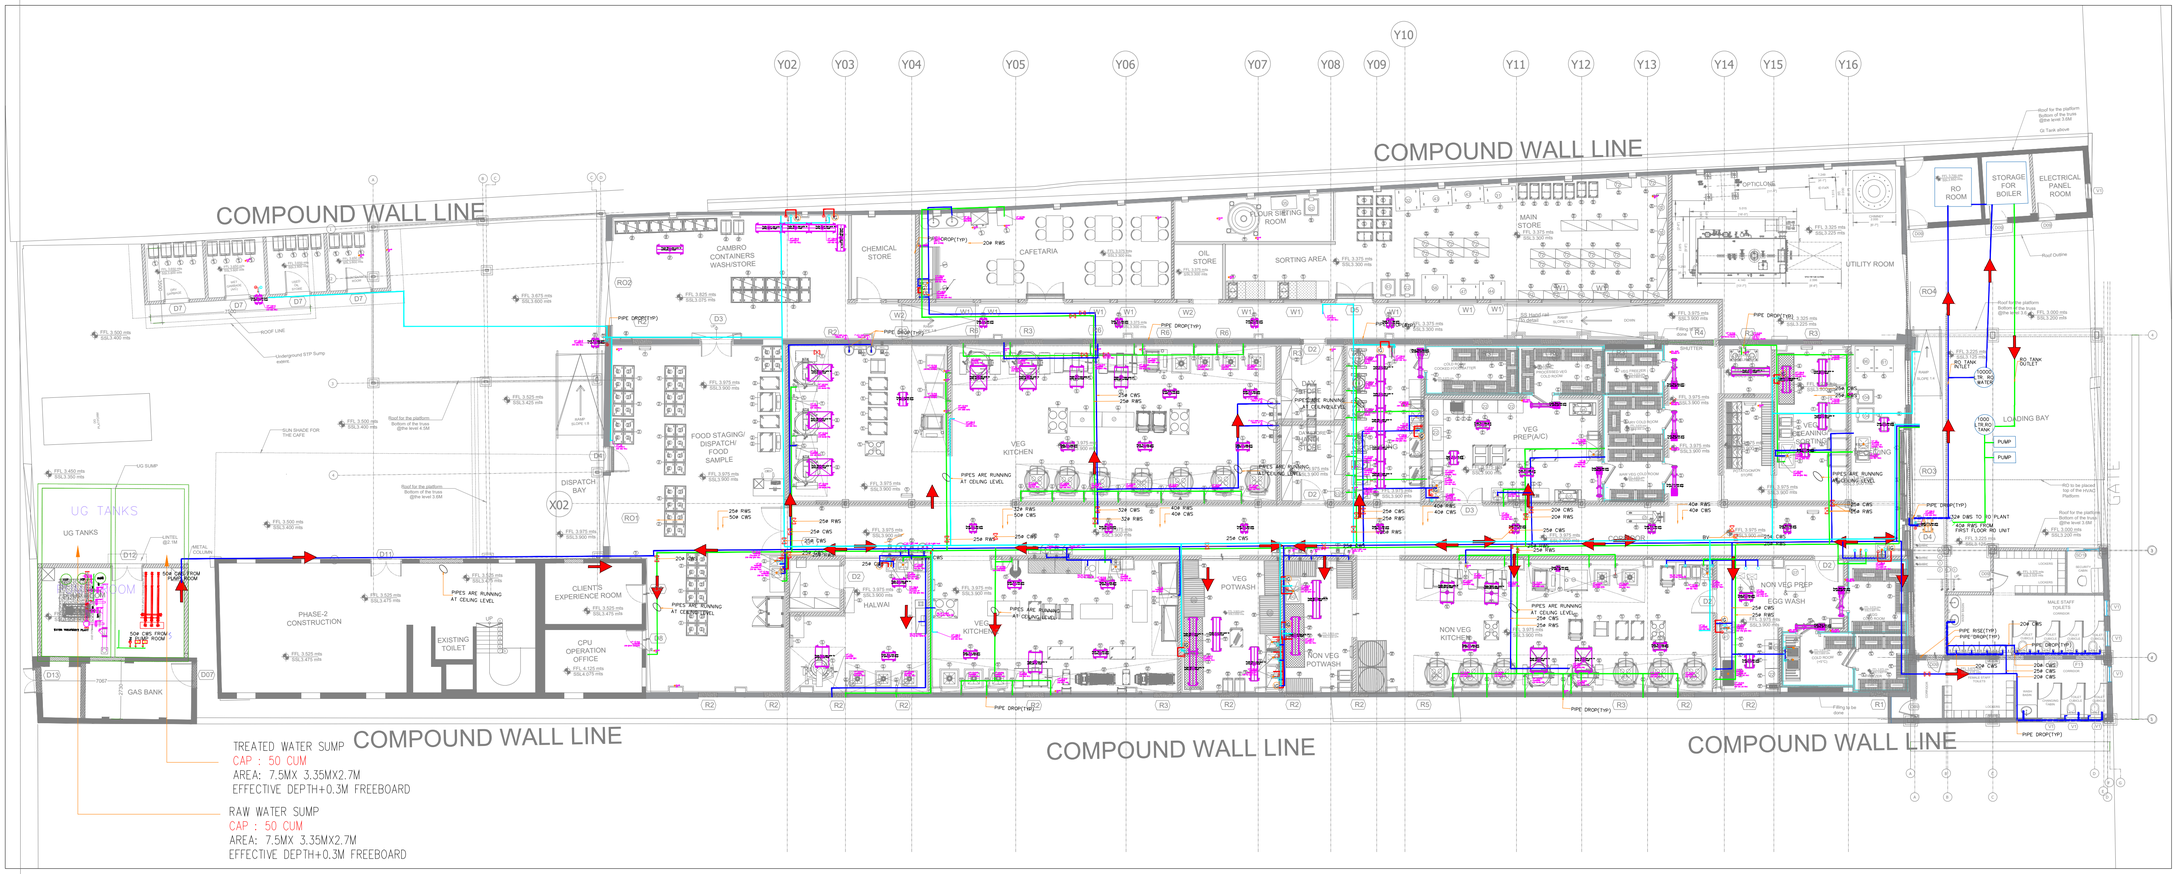


WATER SUPPLY LEGENDS:

CWS PIPE	
HWS PIPE	
RWS PIPE	
BALL VALVE/ ISOLATION VALVE	
CWS-COLD WATER SUPPLY	
HWS-HOT WATER SUPPLY	
RWS-RO WATER SUPPLY	

NOTES:

1- All dimensions are in metres.
2- All drawings are the sole property of "DESIGN TRANSCEND"
3- No part of this drawing should be reproduced, copied or exchanged without the written permission of the architect.
4- Refer dimensions for actual dimensions. Do not measure from the drawing.

STRUCTURAL DESIGN:

SRI SAI ENGINEERS
SERVICE - SPLENDID - EVERLASTING
No.243, 3rd Main, Kirloskar Layout
Nagasandra Post, Bangalore-560073.
Tel No. +919731754659,
Email : anand@srisaiengg.com,
Website : www.srisaiengg.com

MEP DESIGN:

maverick
SERVICE CONSULTANTS

MEP CONSULTANTS :
MAVERICK SERVICE CONSULTANTS
#48, 7th Main,
4th Block, Jaya nagar,
Bangalore-560011.

ARCHITECTS:

DESIGN TRANSCEND
Transforming lives through design

3rd Floor, Rishab Arcade, Sanjay Nagar Main Rd
Raj Mahal Vilas 2nd Stage, Bengaluru - 560094

CLIENT:

COMPASS CPU
CHENNAI

Plot No 147B and 162B,
EE Industrial Estate, OMR, Perungudi,
Chennai - 600 096.

CONTRACTOR

RIYA ENTERPRISES
Second Floor, C-19,
Dilshad Colony, New Delhi
0095 (Above SBI Bank)
Email: facilities@riyaenterprises.in

PROJECT NAME:

COMPASS CPU,
CHENNAI

DRAWING NAME:

AS - BUILT DOMESTIC, RO AND HOT WATER SUPPLY LAYOUT

REVISIONS :

NO.	DATE	DESCRIPTION

REFERENCE

AR | CPU | 101

DATE: 19TH MARCH 2026

DRAWN BY:	CHECKED BY:
MOHIT KUMAR	MR. SARIM

SCALE 1:100

SHEET A0

N