

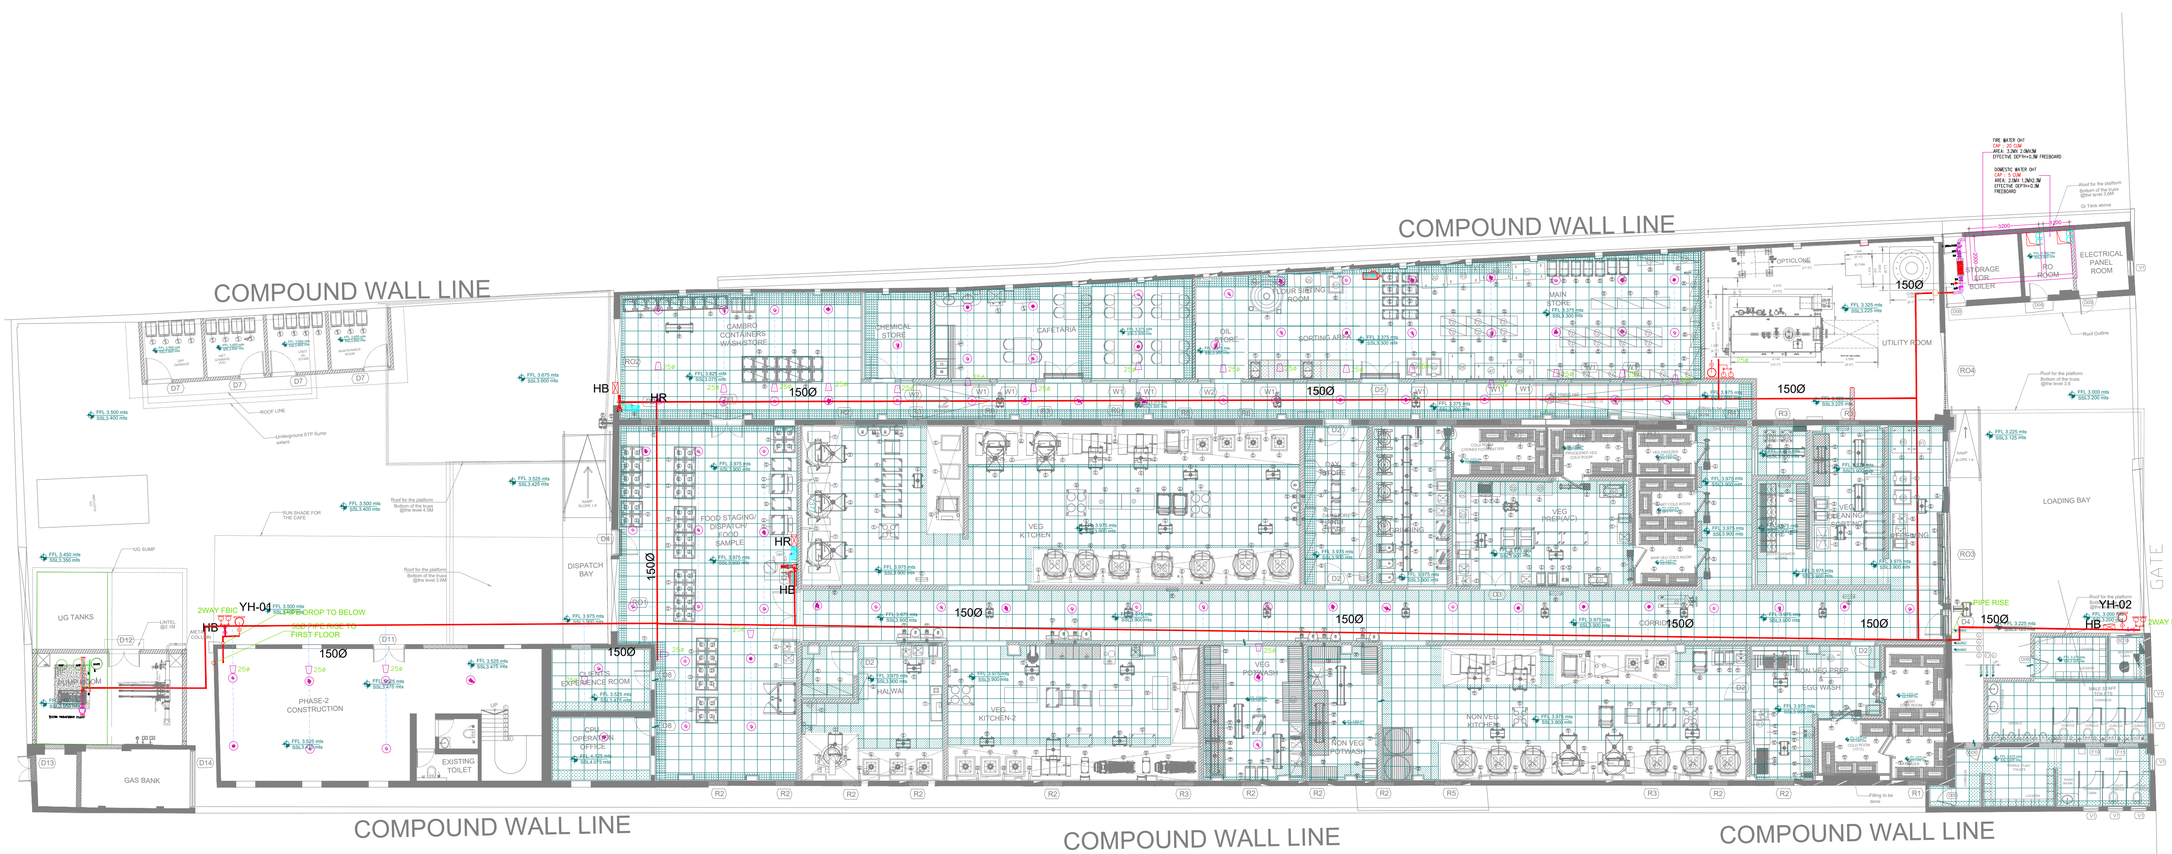


FIRE LEGENDS

	FIRE PIPE
	2WAY FBIC
	YARD HYDRANT
	HOSE REEL
	HOSE BOX
	INTERNAL HYDRANT
	BUTTERFLY VALVE
	PENDENT SPRINKLER

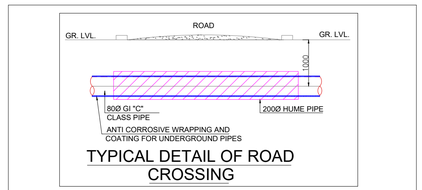

TYPICAL DETAIL OF ROAD CROSSING

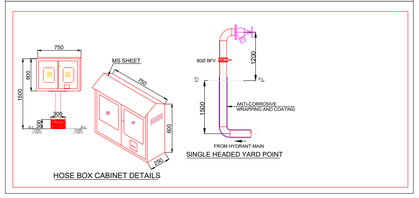

HOSE BOX CABINET DETAILS

SINGLE HEADED YARD POINT

NOTES:

1- All dimensions are in metres.
2- All drawings are the sole property of "DESIGN TRANSCEND"
3- No part of this drawing should be reproduced, copied or exchanged without the written permission of the architect.
4- Refer dimensions for actual dimensions. Do not measure from the drawing.

STRUCTURAL DESIGN:

SRI SAI ENGINEERS
SERVICE - SPLENDID - EVERLASTING
No.243, 3rd Main, Kirloskar Layout
Nagasandra Post, Bangalore-560073.
Tel No. +919731754659,
Email : anand@srisaiengg.com,
Website : www.srisaiengg.com

MEP DESIGN:

maverick SERVICE CONSULTANTS

MEP CONSULTANTS :
MAVERICK SERVICE CONSULTANTS
#48, 7th Main,
4th Block, Jaya nagar,
Bangalore-560011.

ARCHITECTS:

DESIGN TRANSCEND
Transforming lives through design
3rd Floor, Rishab Arcade, Sanjay Nagar Main Rd
Raj Mahal Vilas 2nd Stage, Bengaluru - 560094

CLIENT:

COMPASS GROUP

Plot No 147B and 162B,
EE Industrial Estate, OMR, Perungudi,
Chennai - 600 096.

CONTRACTOR

RIYA ENTERPRISES
Second Floor, C-19,
Dilshad Colony, New Delhi
110095 (Above SBI Bank)
Email: facilities@riyaenterprises.in

PROJECT NAME:

COMPASS CPU,
CHENNAI

DRAWING NAME:

AS - BUILT FIRE SPRINKLER,FIRE HYDRANT & FIRE EXTINGUISHERS LAYOUT

REVISIONS :

NO.	DATE	DESCRIPTION

REFERENCE

AR | CPU | 101

DATE: 16 TH JULY 2026

DRAWN BY:	CHECKED BY:
MOHIT KUMAR	MR. SARIM

SCALE 1:100

SHEET A0

N