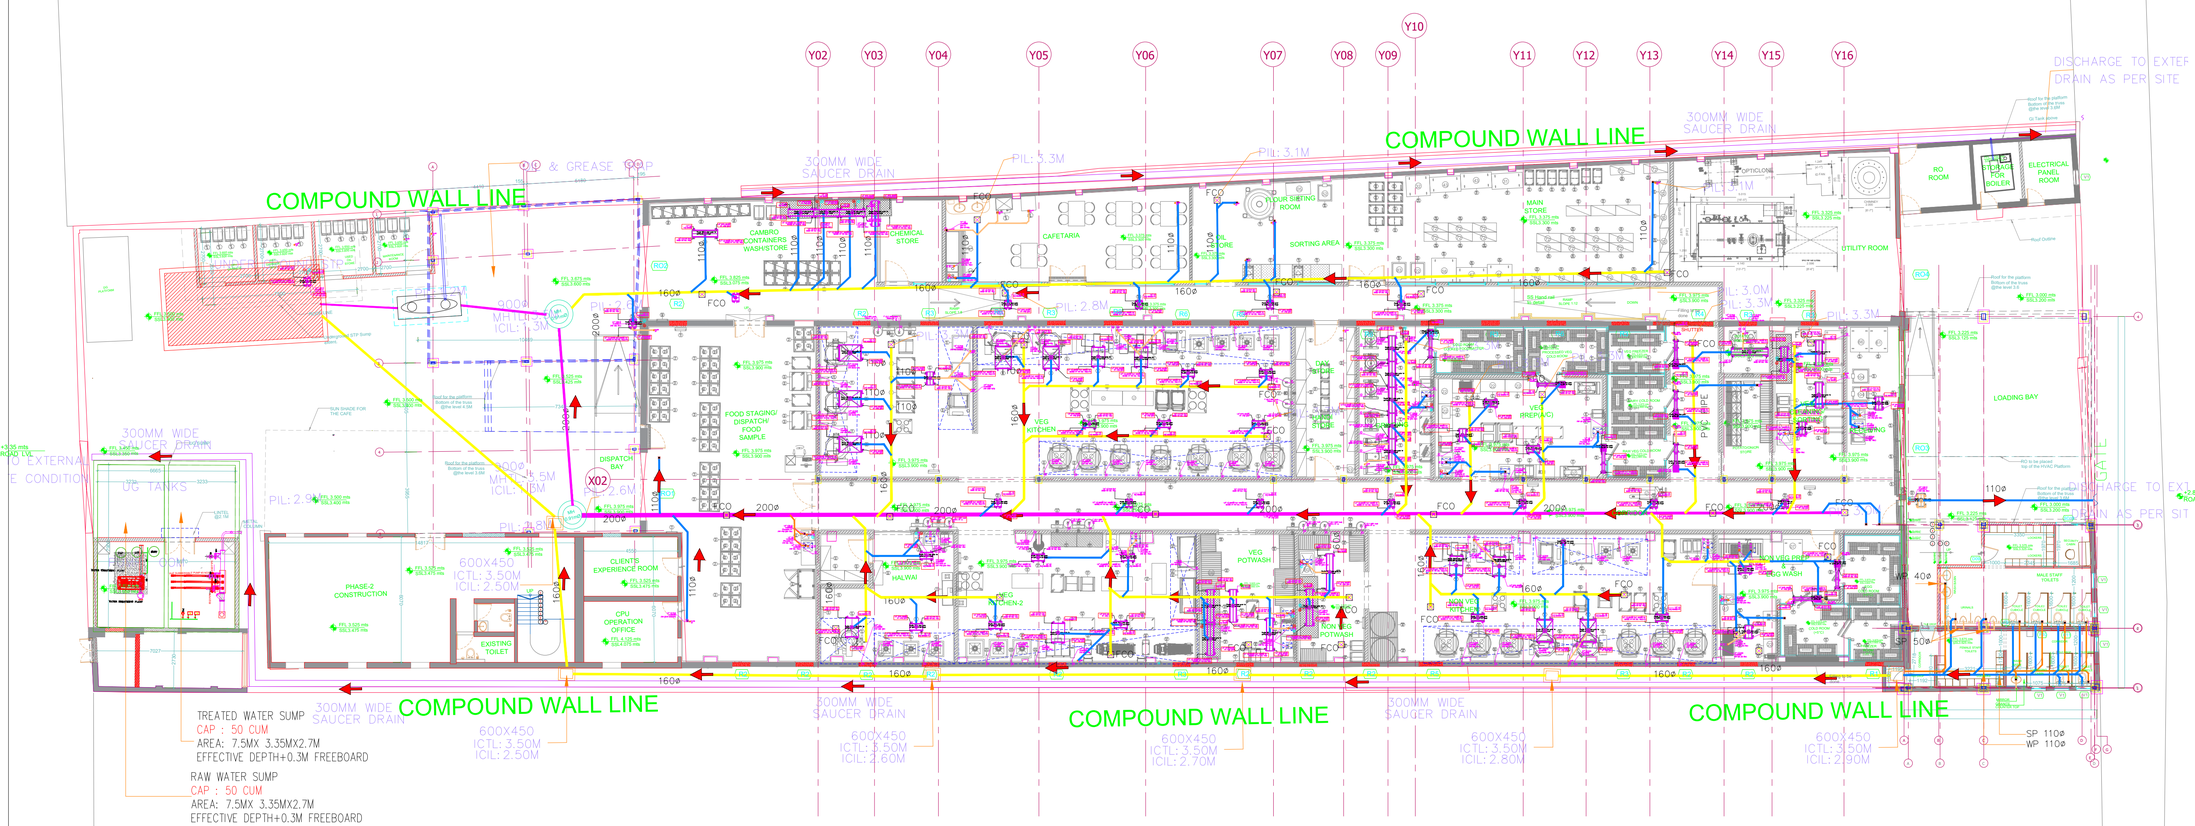


GROUND FLOOR PLAN

NOTE:ALL THE LINES TO BE PERPENDICULAR TO EACH OTHER
COLUMN AREA TO BE FINISHED PROPERLY SO THE DADO IS IN LINE

DRAINAGE & STORM WATER LEGENDS:

	FLOOR CLEAN OUT
	FLOOR TRAP
	40ø WASH BASIN WASTE PIPE 50ø SINK WASTE PIPE
	75ø TOILET WASTE PIPE
	100ø KITCHEN WASTE PIPE
	160ø KITCHEN WASTE PIPE
	200ø KITCHEN WASTE PIPE

SCHEDULE OF DOOR OPENING

DOOR NAME	DOOR TYPE	DOOR SIZE	DESCRIPTION
D1	FIRE DOOR,DOUBLE LEAF METAL DOOR	2.35 W x 2.10 H	DOOR OPENING TO FOOD DISPATCH
D2	NON-FIRE DOOR,SINGLE LEAF METAL DOOR	1.20 W x 2.10 H	DOOR OPENING TO PRODUCT STORE,NON-VEG KITCHEN NON-VEG PREP,ENTRY AND EXIT DAY STORE
D3	NON-FIRE DOOR,DOUBLE LEAF METAL DOOR	1.50 W x 2.10 H	DOOR OPENING TO VEG PREP AC AND FOOD STAGING
D4	FIRE DOOR,SINGLE LEAF METAL DOOR	1.20 W x 2.10 H	DOOR OPENING TO ENTRANCE TO KITCHEN
D5	NON-FIRE DOOR,DOUBLE LEAF METAL DOOR	1.80 W x 2.10 H	DOOR OPENING TO MAIN STORE
D6	UPVC,SINGLE LEAF UPVC DOOR	1.20 W x 2.10 H	DOOR OPENING TO DETERGENT STORE,HK MATERIAL STORE, NON FOOD STORE,DRY GARBAGE,WET GARBAGE,USED OIL STORE
D7	UPVC,SINGLE LEAF UPVC DOOR	1.20 W x 2.10 H	DOOR OPENING TO DRY GARBAGE,WET GARBAGE, USED OIL STORE AND MAINTENANCE ROOM
D8	EXISTING DOOR	0.950 W x 2.10 H	DOOR OPENING TO CPU OPERATION OFFICE
D9	UPVC,SINGLE LEAF UPVC DOOR	0.90 W x 2.10 H	DOOR OPENING TO STORAGE FOR BOILER,ELE PANEL ROOM AND RO ROOM TOILET OPENING
SD10	UPVC,SLIDING UPVC DOOR	1.50 W x 2.10 H	DOOR OPENING TO SECURITY CABIN
D11	UPVC,DOUBLE LEAF UPVC DOOR	1.50 W x 2.10 H	DOOR OPENING TO CAFETARIA
D12	NON-FIRE DOOR,DOUBLE LEAF METAL DOOR	1.50 W x 2.10 H	DOOR OPENING TO PUMP ROOM
D13	DOUBLE LEAF MESH DOOR	1.20 W x 2.10 H	DOOR OPENING TO GAS BANK

SCHEDULE OF WINDOW OPENING

W01	1.80 W x 0.9 H	VENTILATOR OPENING 1
W02	0.60 W x 0.9 H	VENTILATOR OPENING 2
V1	0.750 W x 0.9 H	VENTILATOR OPENING 1

SCHEDULE OF ROLLING SHUTTER OPENING

RO1	3.30 W x 3.00 H	ROLLING SHUTTER 1 (USING THE EXISTING ONE)
RO2	3.99 W x 3.53 H	ROLLING SHUTTER 2 (USING THE EXISTING ONE)
RO3	4.17 W x 3.35 H	ROLLING SHUTTER 3 (USING THE EXISTING ONE)
RO4	3.53.4 W x 3.35 H	ROLLING SHUTTER 3 (USING THE EXISTING ONE)

NOTES:

1- All dimensions are in metres.
2- All drawings are the sole property of "DESIGN TRANSCEND"
3- No part of this drawing should be reproduced, copied or exchanged without the written permission of the architect.
4- Refer dimensions for actual dimensions. Do not measure from the drawing.

STRUCTURAL DESIGN:

SRI SAI ENGINEERS
SERVICE - SPLENDID - EVERLASTING
No.243, 3rd Main, Kirloskar Layout
Nagasandra Post, Bangalore-560073.
Tel No. +919731754659,
Email : anand@srisaiengg.com,
Website : www.srisaiengg.com

MEP DESIGN:

maverick SERVICE CONSULTANTS

MEP CONSULTANTS :
MAVERICK SERVICE CONSULTANTS
#48, 7th Main,
4th Block, Jaya nagar,
Bangalore-560011.

ARCHITECTS:

DESIGN TRANSCEND
Transforming lives through design
3rd Floor, Rishab Arcade, Sanjay Nagar Main Rd
Raj Mahal Vilas 2nd Stage, Bengaluru - 560094

CLIENT:

COMPASS GROUP
Plot No 147B and 162B,
EE Industrial Estate, OMR, Perungudi,
Chennai - 600 096.

CONTRACTOR

RIYA ENTERPRISES
Second Floor, C-19,
Dilshad Colony, New Delhi
110095 (Above SBI Bank)
Email: facilities@riyaenterprises.in

PROJECT NAME:

COMPASS CPU, CHENNAI

DRAWING NAME:

AS - BUILT PLUMBING LAYOUT

REVISIONS :

NO.	DATE	DESCRIPTION

REFERENCE

AR | CPU | 101

DATE: 19TH MARCH 2026

DRAWN BY:	CHECKED BY:
MOHIT KUMAR	MR. SARIM

SCALE 1:100

SHEET A0

N